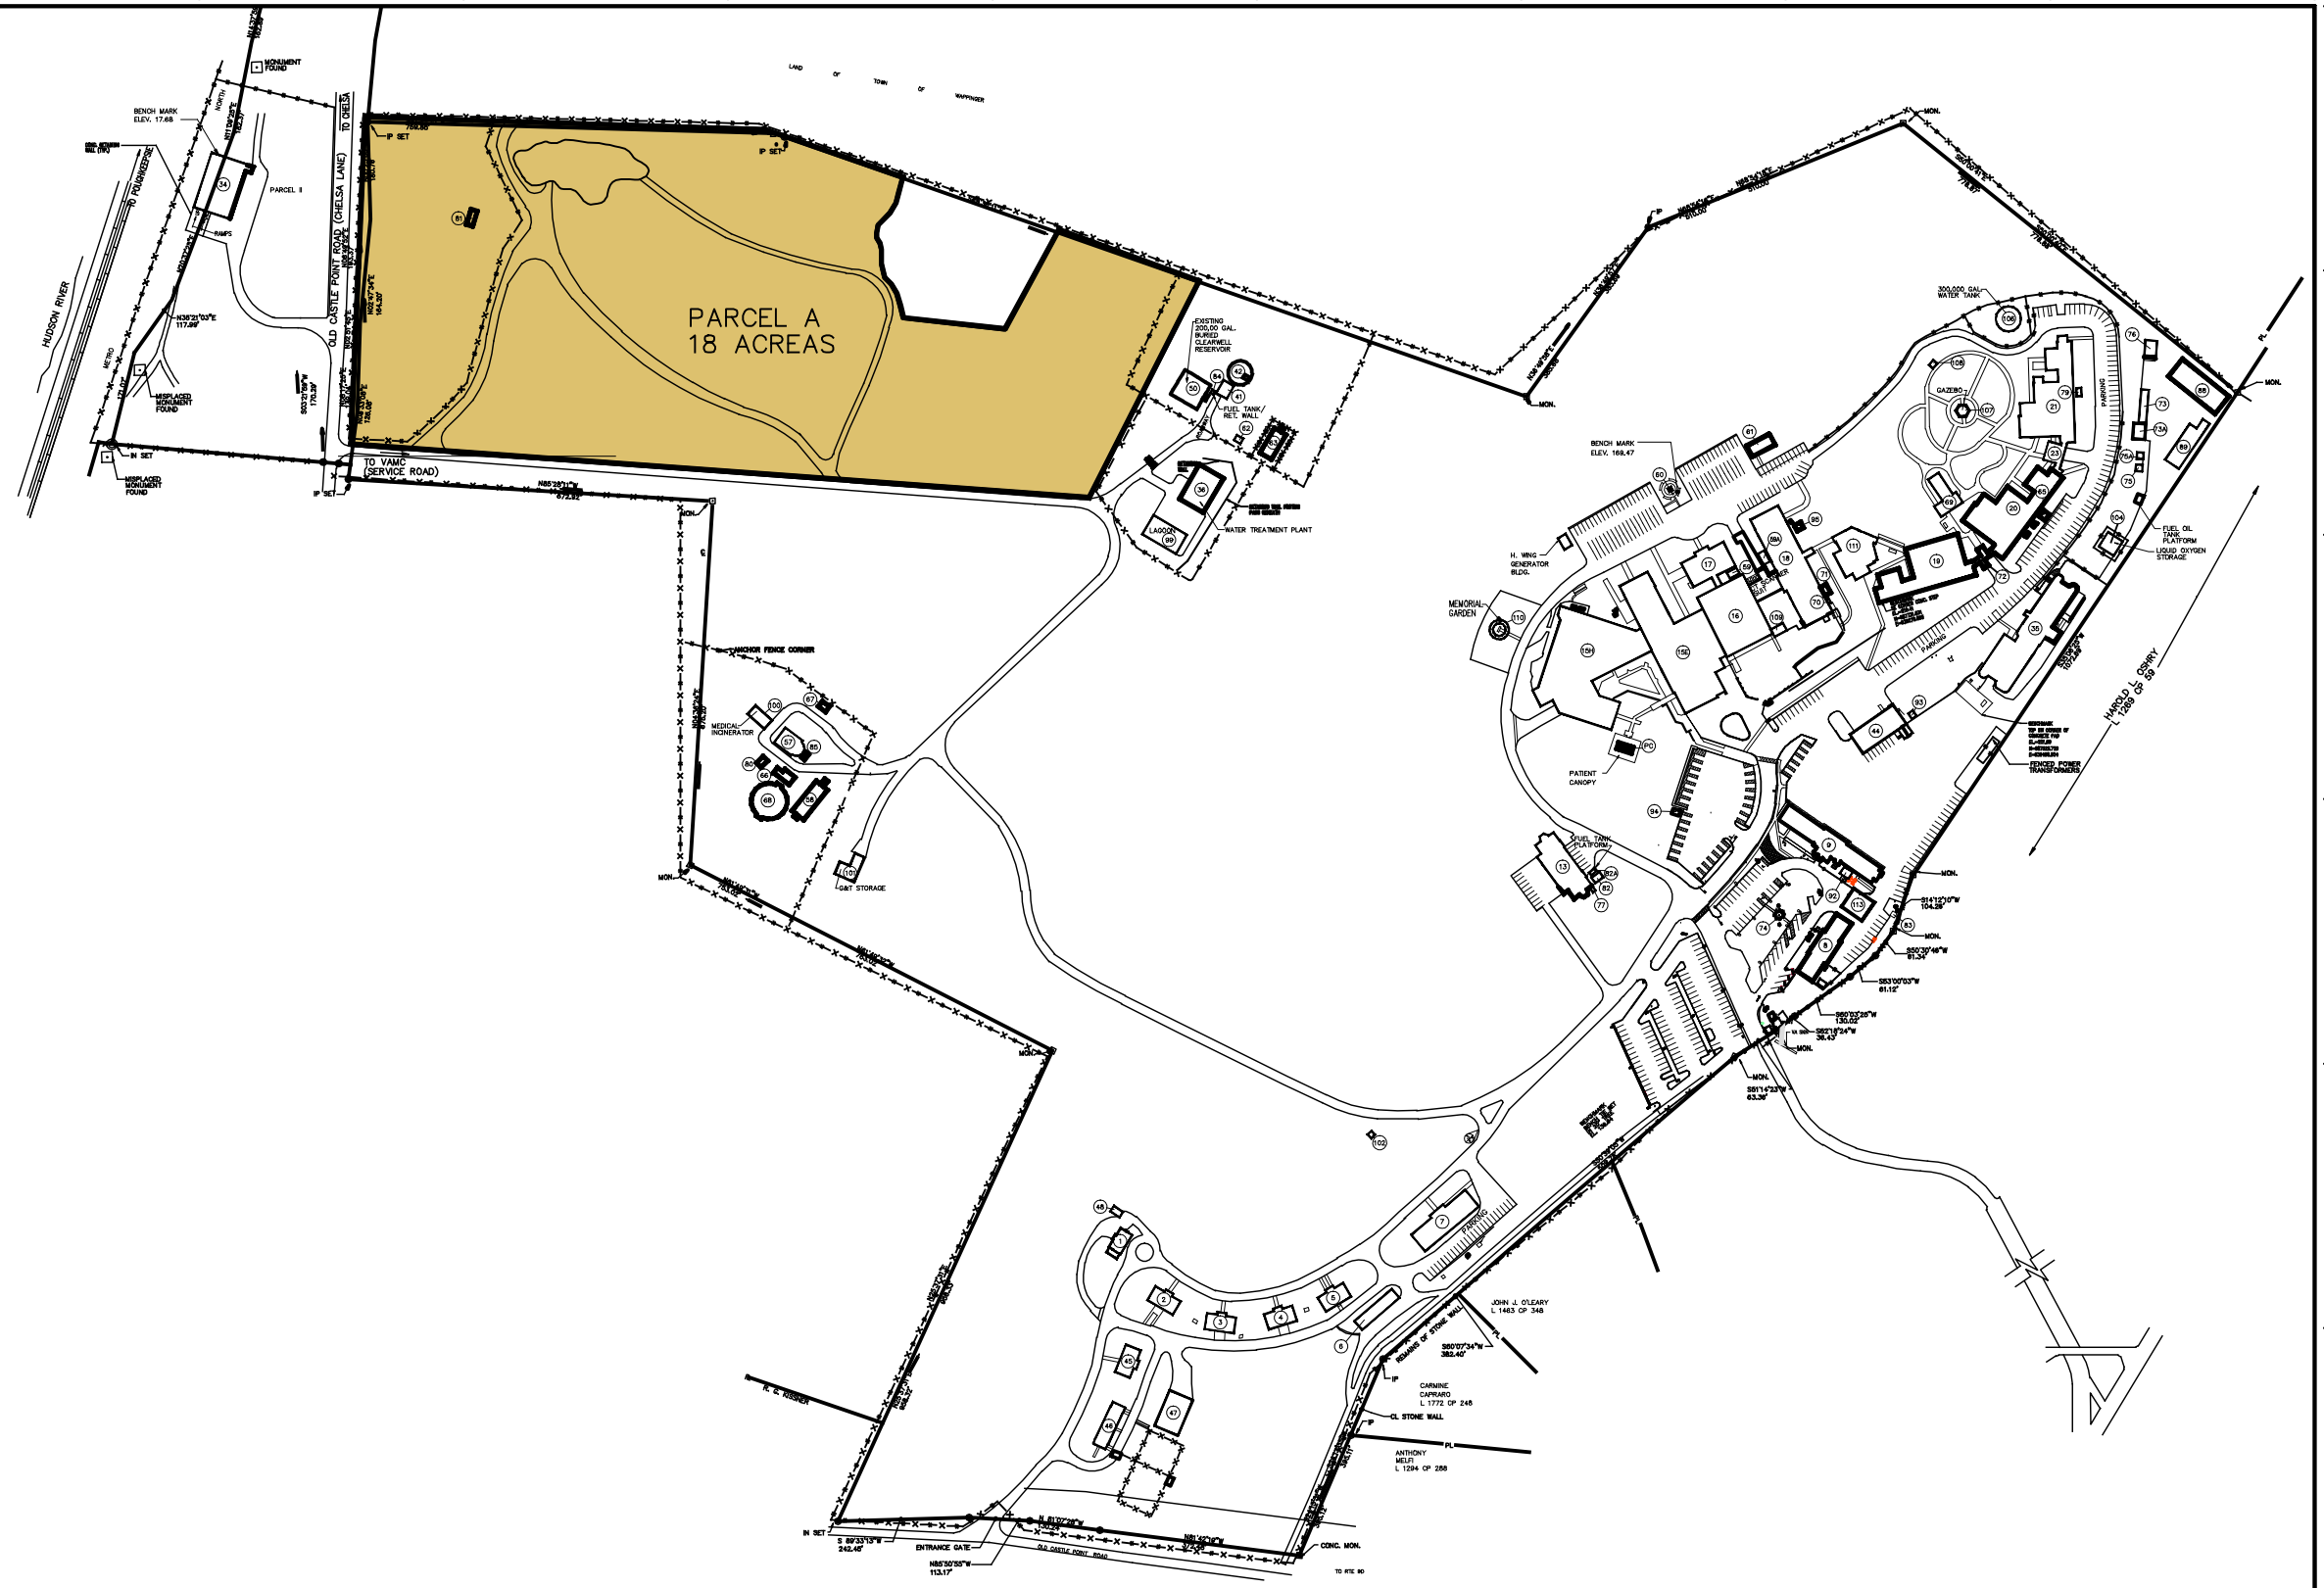

SITE INDEX	02-11-2007
STRUCTURAL ADDITIONS AND TITLE UPDATE	02-15-2007
PARKING EXPANSION	09-12-2006
AS-BUILT (INDUS SYSTEMS)	07-06-2005
Revisions	Date

CONSULTANTS:

ARCHITECT/ENGINEERS:

NORTH:

APPROVED:

APPROVED:

APPROVED:

APPROVED:

APPROVED:

APPROVED:

APPROVED:

APPROVED:

Drawing Title: CAMPUS SITE PLAN BUILDING LOCATIONS

Approved Director, VA-NHCS:

Approved Chief of Engineering:

Project Title:

Location: CASTLE POINT, NEW YORK

Date: 02-15-2007 | Checked: | Drawn: AM

Project Number: N/A

Building Number: N/A

Drawing Number: SP-01

Engineering Service

VA FORM 08-6231, OCT 1978