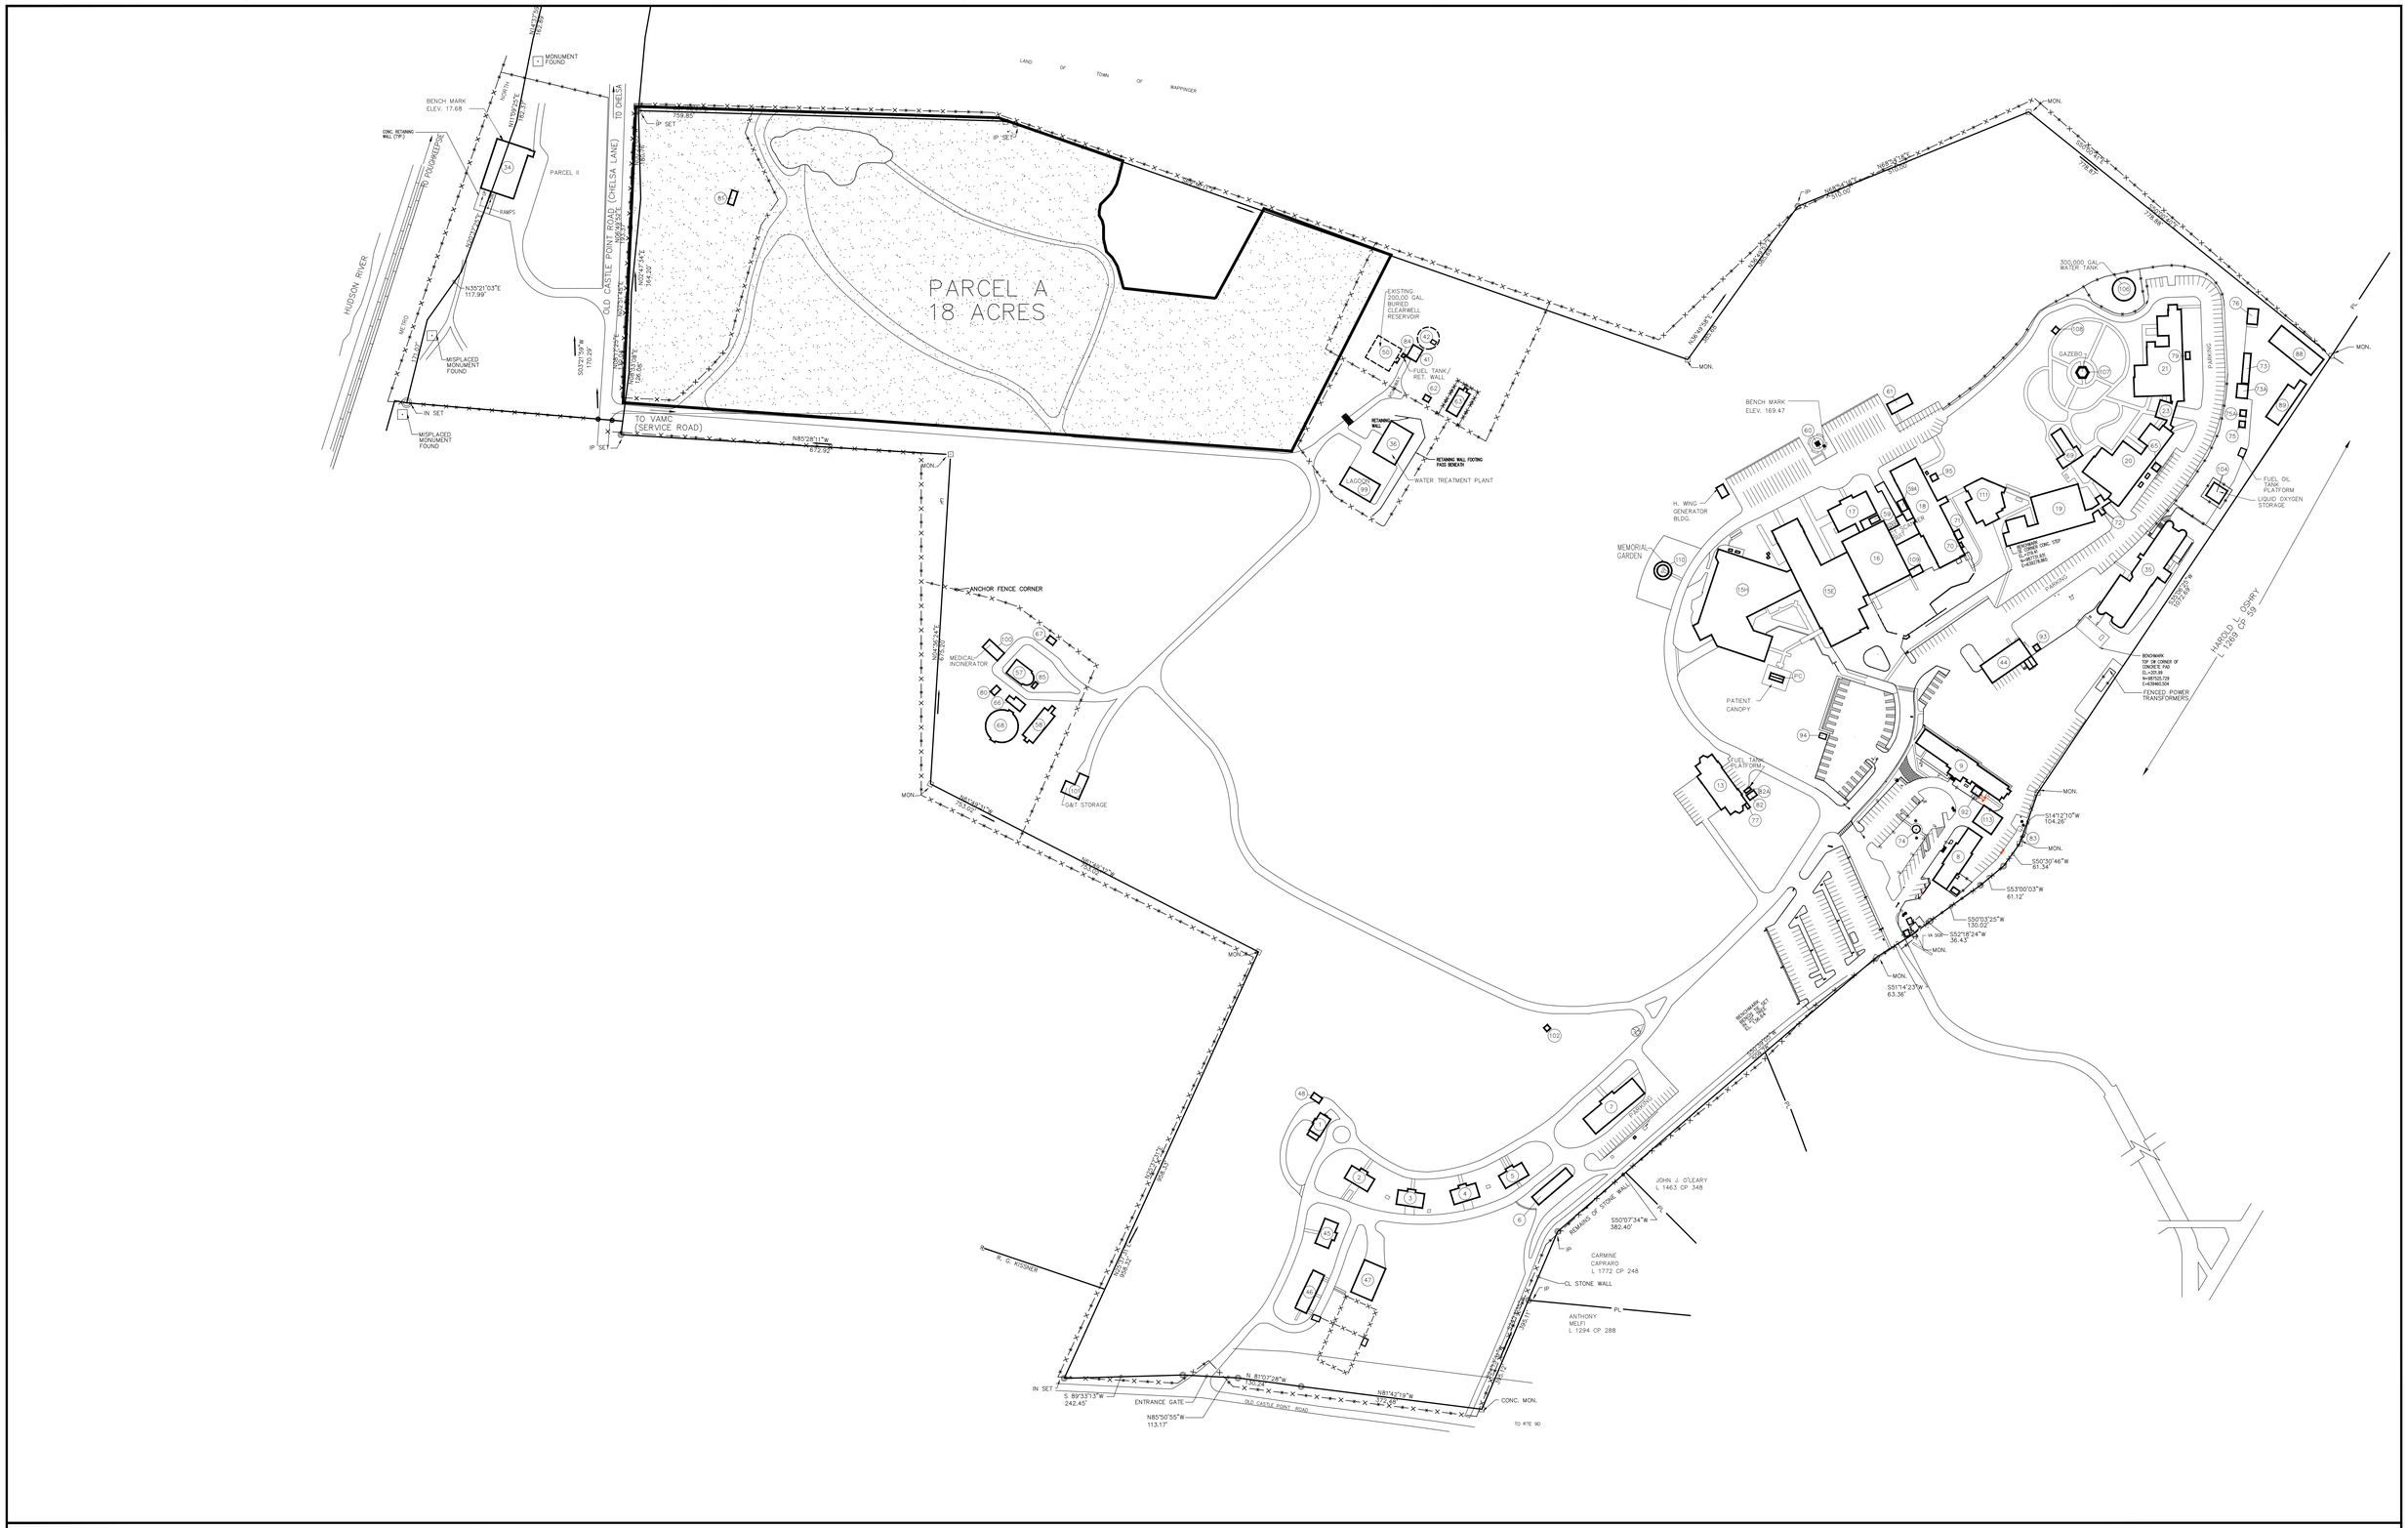

SITE INDEX	03-01-2007
STRUCTURAL ADDITIONS AND TITLE UPDATE	02-15-2007
PARKING EXPANSION	06-12-2006
AS-BUILT (INDUS SYSTEMS)	07-06-2005
Revisions:	Date:

CONSULTANTS:

ARCHITECT/ENGINEERS:

NORTH:

APPROVED:

APPROVED:

APPROVED:

APPROVED:

APPROVED:

APPROVED:

APPROVED:

APPROVED:

Drawing Title: CAMPUS SITE PLAN BUILDING LOCATIONS

SCALE 1" = 120'-0"

Approved: Director , VAHVHCS:

Approved: Chief of Engineering

Project Title

Location: CASTLE POINT, NEW YORK

Date: 02-15-2007

Checked

Drawn: AMI

Project Number: N/A

Building(s) Number: N/A

Drawing Number: SP-01

Engineering Service

Department of Veterans Affairs

VA FORM 08-6231, OCT 1978